

January 4, 2007

**ADDENDUM NO. 1
TO
THE PLANS AND SPECIFICATIONS
FOR
SENTER ROAD WIDENING PROJECT – PHASE II
(TULLY ROAD TO SINGLETON ROAD)**

Notice is hereby given that the following revisions, additions and/or deletions are hereby made part of, and incorporated into the Plans and Specifications for the Senter Road Widening Project – Phase II (Tully Road to Singleton Road).

IMPORTANT

THIS ADDENDUM SHOULD BE ACKNOWLEDGED WHEN YOUR BID IS SUBMITTED. FAILURE TO ACKNOWLEDGE THE ADDENDUM MAY CONSTITUTE GROUNDS FOR REJECTION OF THE BID.

INSTRUCTIONS:

The bidder must sign this addendum in the space provided below and return one signed copy with the bid. Failure to return the signed copy with the bid document shall not relieve the bidder of his/her obligation to include this addendum in the bid proposal.

Bidder's Name

Approved By:

Signature and Title of Bidder



TIMM BORDEN
Deputy Director of Public Works Department

Date

THIS ADDENDUM CONTAINS 3 PAGES

Changes in the Specifications:

- Item 1 **REVISE** first paragraph, under NOTICE TO CONTRACTORS, PLANS AND SPECIFICATIONS, on Page 1 of 3, to read as follows:

Plans and Specifications may be purchased at **Peninsula Digital Imaging, 599 Fairchild Drive, Mountain View, CA 94043** for a non-refundable charge of **Sixty-Three Dollars (\$63.00)** per set. Bidders requesting that sets be mailed to them will be charged the full cost of shipping. Additional full or partial sets can be purchased for the full cost of reproduction from the location listed above. Addenda (if any) will be provided free of charge to all registered plan holders, and to various builders exchange locations. Please make checks payable to Peninsula Digital Imaging.

- Item 2 **REVISE** second paragraph, under NOTICE TO CONTRACTORS, PLANS AND SPECIFICATIONS, on Page 1 of 3, to read as follows:

Plans, specifications, any addendum, and plan holders list can also be viewed online by going to the Peninsula Digital Imaging website, <http://www.peninsuladigital.com>, (click on the Plan Well logo, then click “go” on the “Public Planroom” area). Please call Peninsula Digital Imaging at (650) 967-1966 for all questions regarding viewing or purchasing of plans and specifications sets for the project.

Changes in the Plans:


- Item 1 **REVISE** plan on Sheet No. 8, STA 103+78.00, 46' RT., to read the note as follows: “RELOCATE AND ADJUST WATER VALVE & ELECTRICAL ANODE TO GRADE.” (See Attachment No.1)
- Item 2 **REVISE** plan on Sheet No. 8, STA 103+78.00, 50' RT., to read the note as follows: “RECYCLED WATER METER VAULT TO BE ADJUSTED TO GRADE.” (See Attachment No.1)

ANDREW HILL HIGH SCHOOL
BRYAN ROSEVEAR
(408) 347-4259

—RECYCLED WATER METER VAULT TO BE
ADJUSTED TO GRADE ~~BY SBWR~~.

~~SPWR TO~~ RELOCATE AND
ADJUST WATER VALVE & ELECTRICAL
ANODE TO GRADE

GUY WIRE TO BE RELOCATED BY PG&E
UTILITY POLE TO BE RELOCATED
BY PACBELL /AT&T

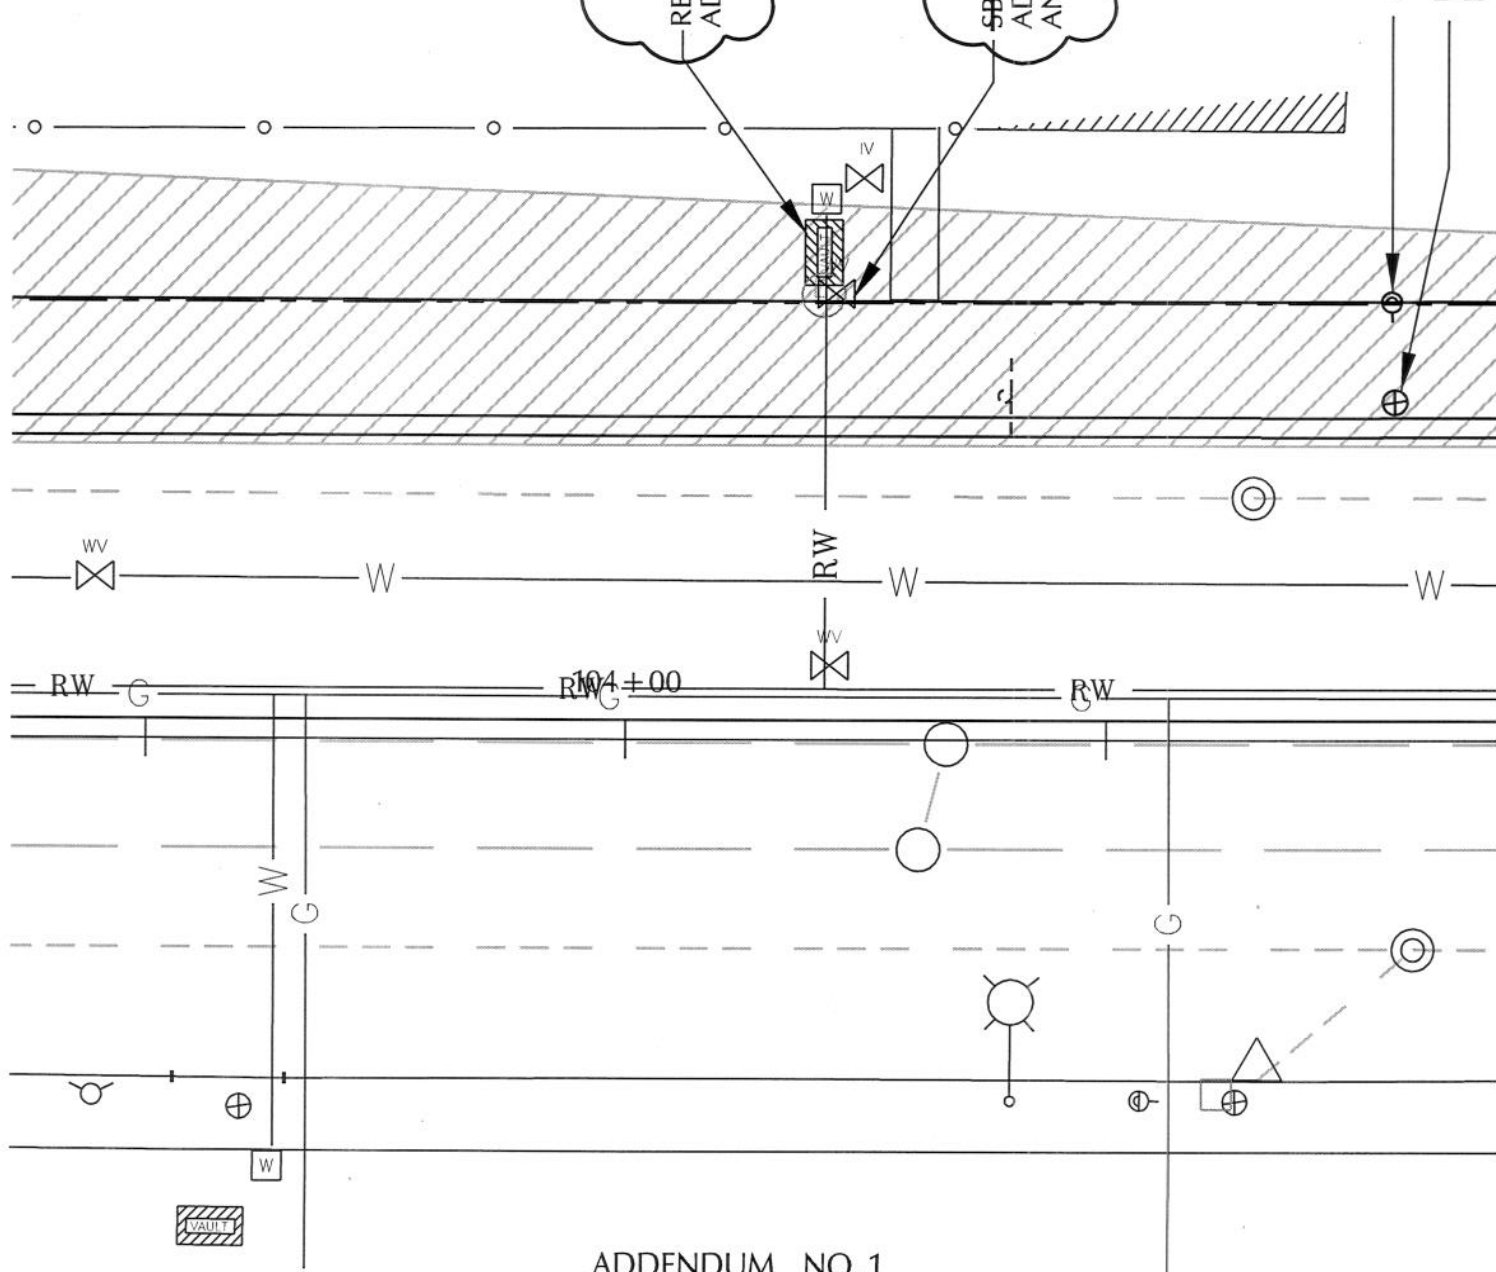

ADDENDUM NO.1
EXISTING CONDITIONS AND DEMOLITION PLAN SHEET 8
ATTACHMENT NO.1